


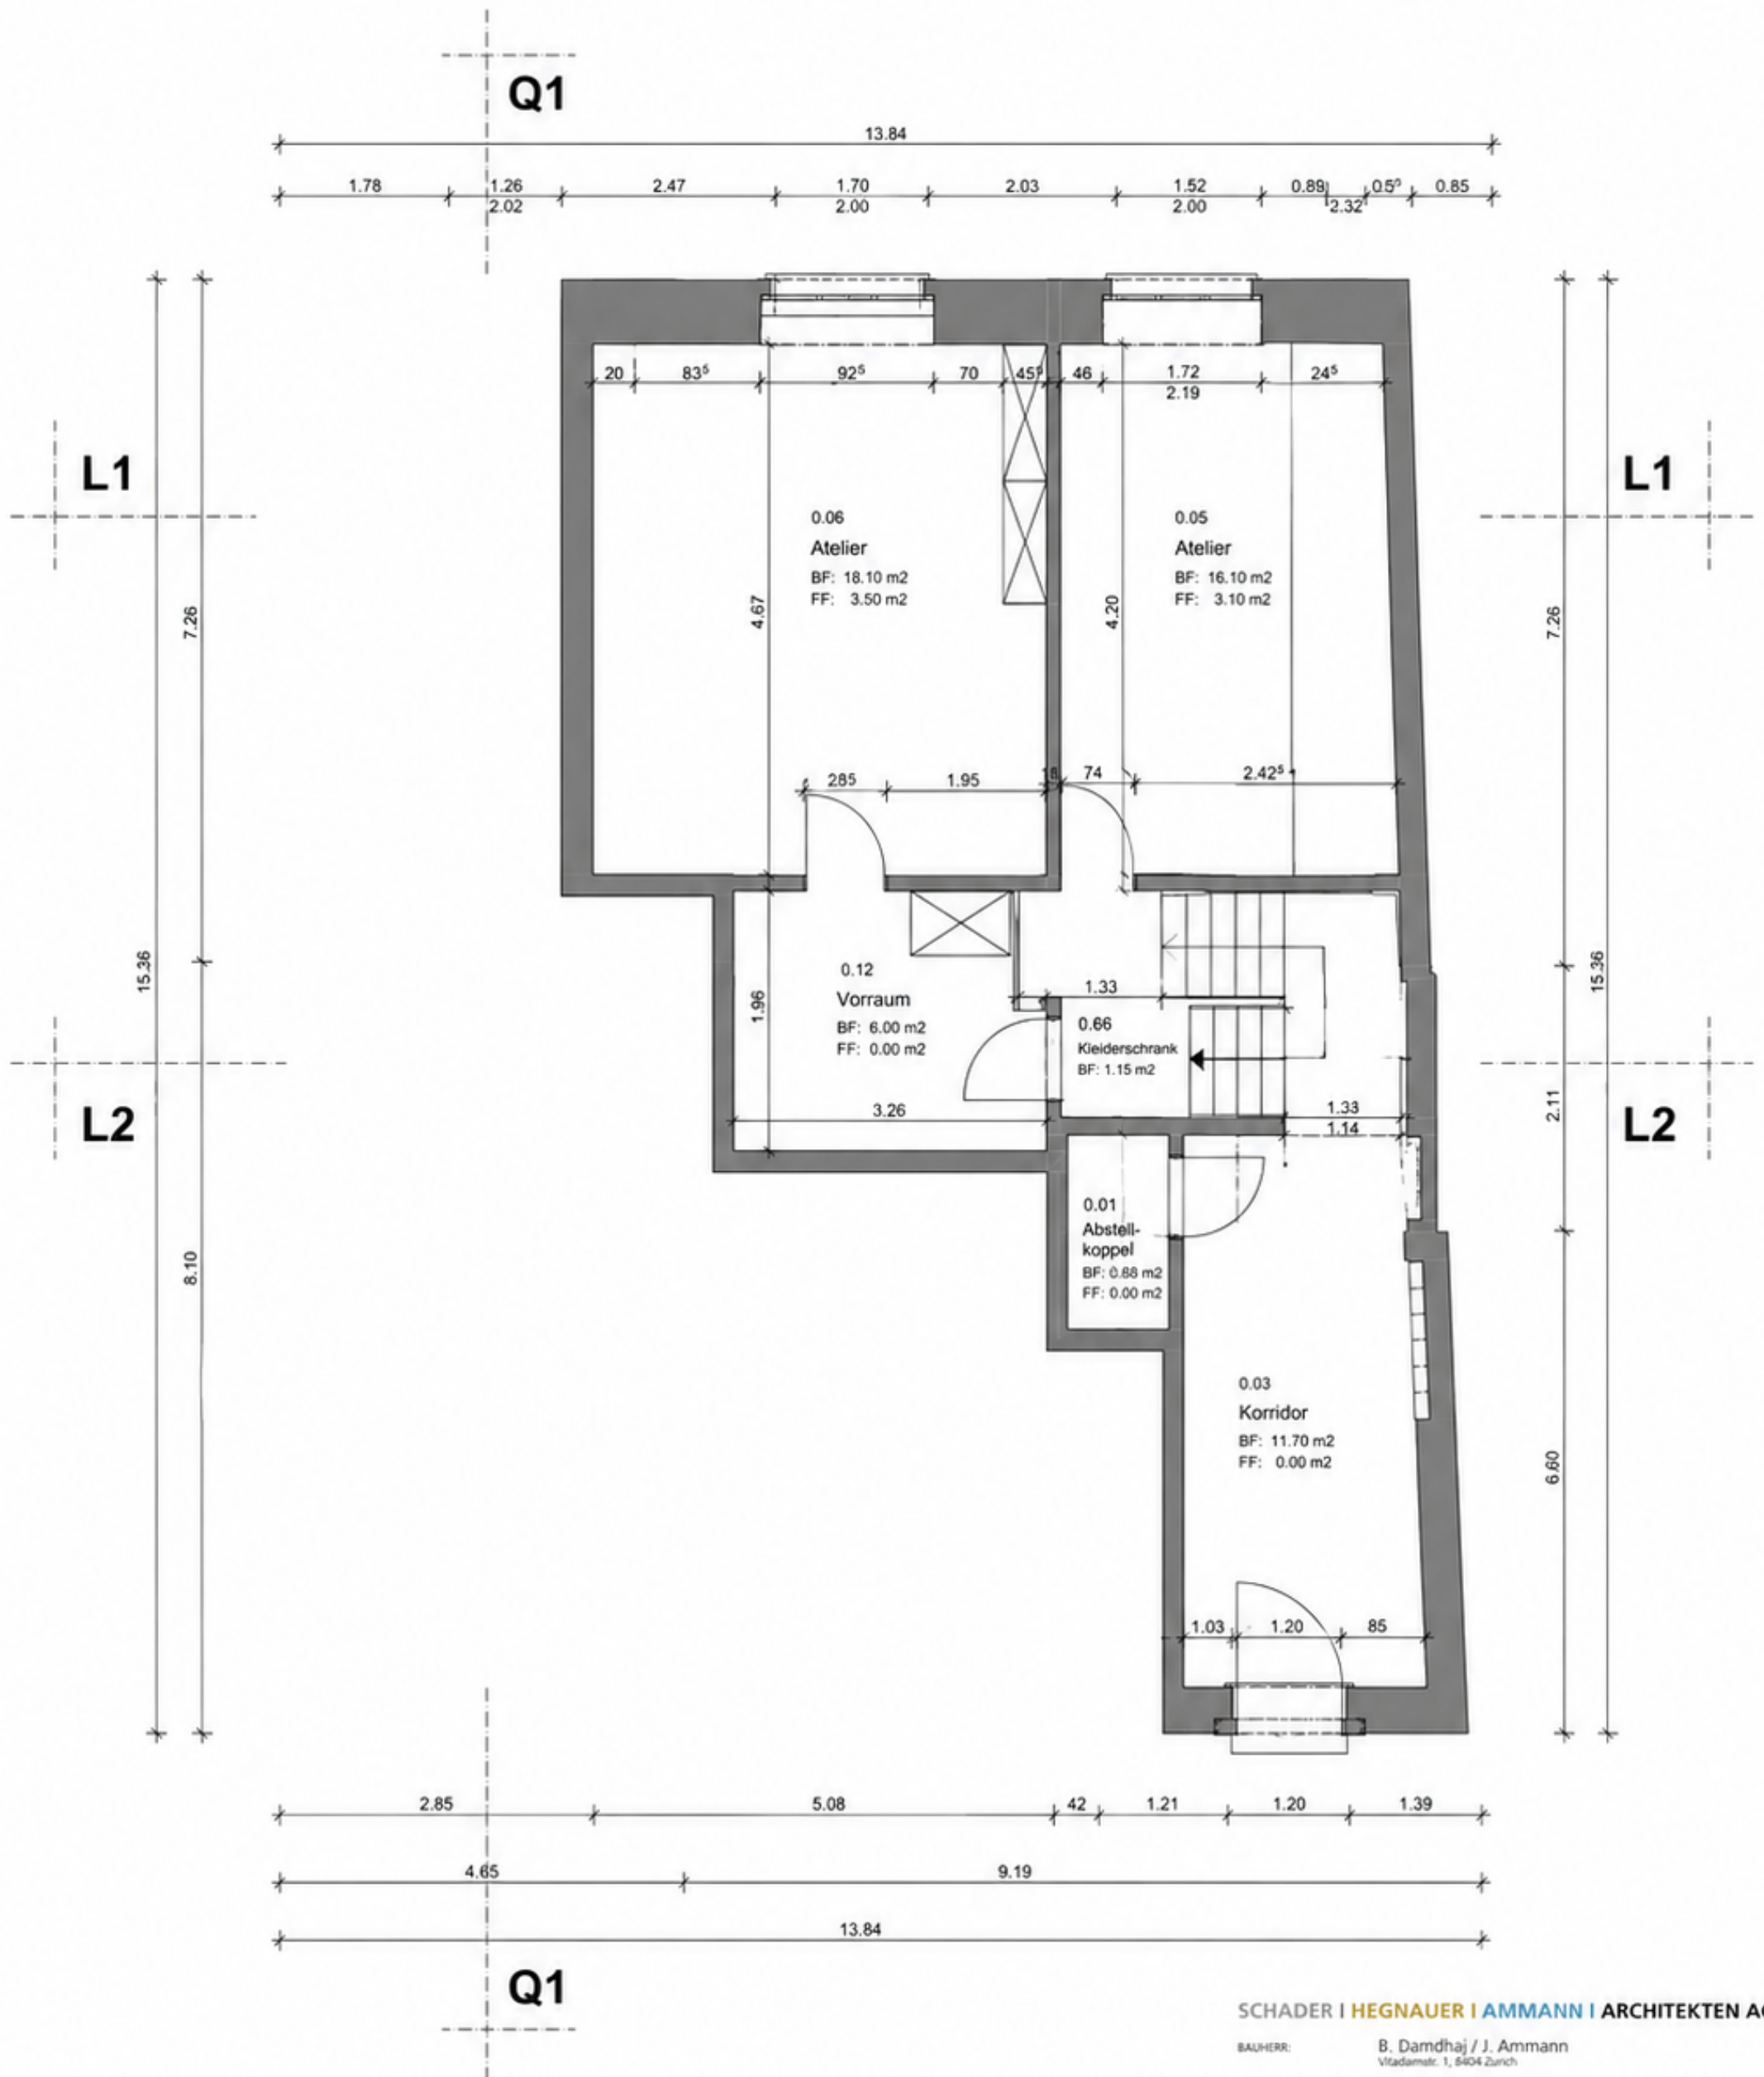

SCHADER | HEGNAUER | AMMANN | ARCHITEKTEN AG

BAUHERR:	B. Damdhaj / J. Ammann Vitadammstr. 1, 8404 Zurich		
ARCHITEKT:	Schader Hegnauer Ammann Architekten AG Vitadammstr. 1, 8404 Zurich, Tel. 044 342 32 00, E-Mail: office@shaa-arch.ch		
OBJEKT:	MFH DÜDORFSTRASSE DÜDORFSTRASSE 57, 8008 ZÜRICH		
PLANINHALT:	Revisionsplan Erdgeschoss		
MST:	1:50	FMT:	A3 hoch
GEZ:	3	DAT:	15.01.2024, jr
		FFST:	240115_Duedorfstr_57aa_Revisionsplan.pln